


# WEST SHADY NINE OFFICE BUILDING

## 1<sup>st</sup> Floor

WEST SHADY NINE  
FIRST FLOOR

6600 CITY WEST PARKWAY  
EDEN PRAIRIE, MN

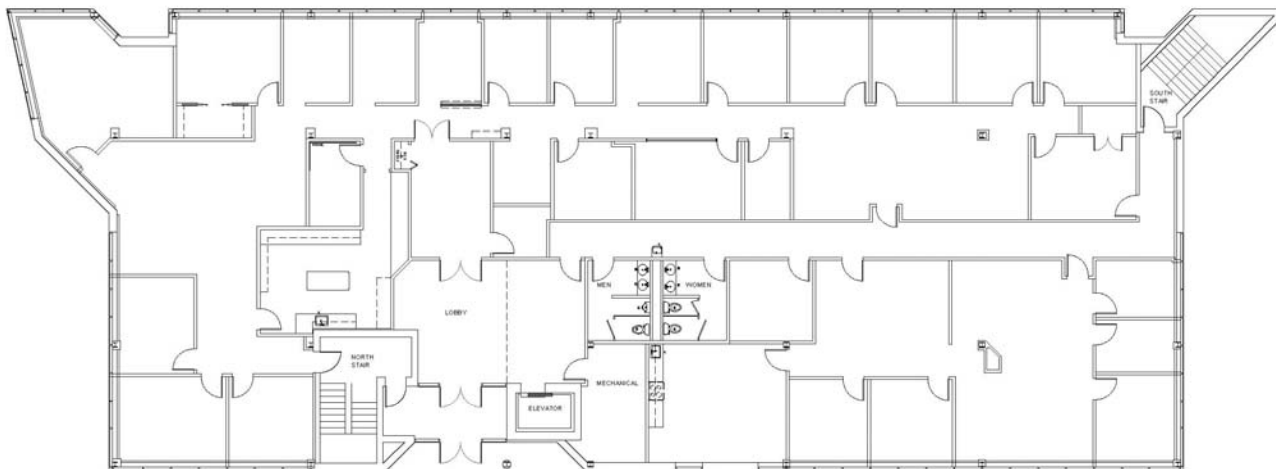

1 FLOOR PLAN: FIRST FLOOR  
1 AS BUILT

SCALE: 1/16" = 1'-0"



KRAUS-ANDERSON  
REALTY COMPANY

WCL  
Associates, Inc.

Architectural  
Interiors

4011 Grand Drive  
Suite 200  
30 Louis Park, Minnesota  
55425  
T: 952.548.9999  
F: 952.548.9554  
www.wcl.com

APRIL 30, 2008

### WEST SHADY NINE

6600 City West Parkway, Eden Prairie, Minnesota

#### CONTACT:

Gary Ryan

952.948.9406 Direct

[gryan@karealty.com](mailto:gryan@karealty.com)



KRAUS-ANDERSON REALTY COMPANY


Development • Leasing • Management

# WEST SHADY NINE OFFICE BUILDING

## 2<sup>nd</sup> Floor

WEST SHADY NINE  
SECOND FLOOR

6600 CITY WEST PARKWAY  
EDEN PRAIRIE, MN

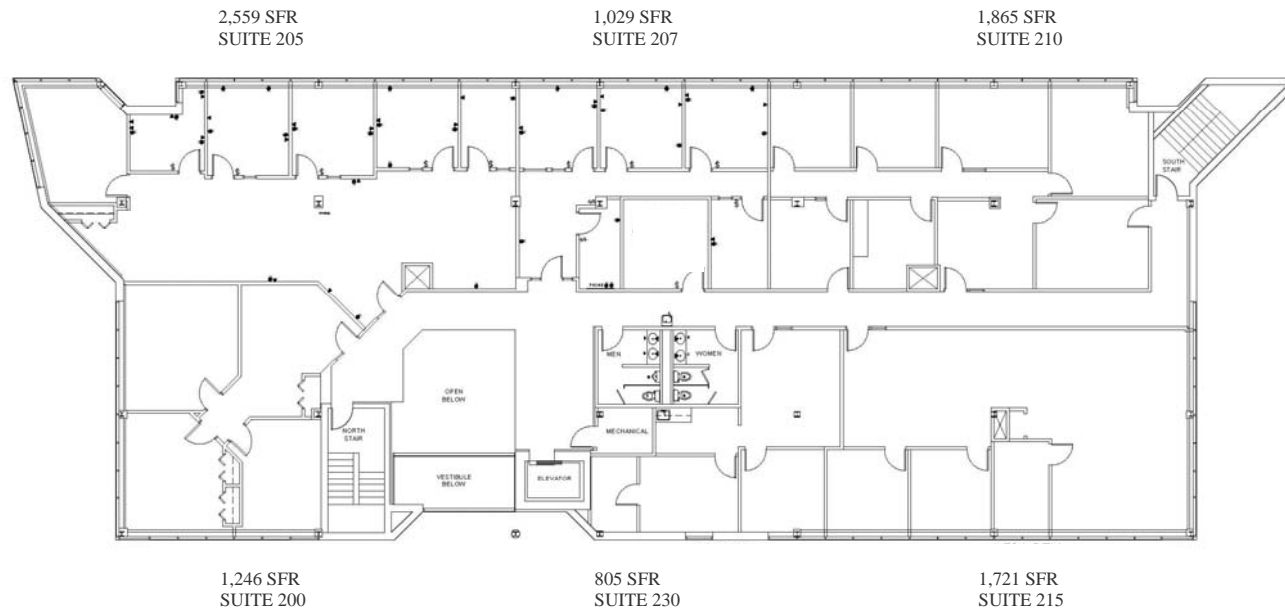

2  
1 FLOOR PLAN: SECOND FLOOR  
AS BUILT

SCALE: 1/16" = 1'-0"



KRAUS-ANDERSON  
REALTY COMPANY

WCL  
Associates, Inc.

Architectural  
Interiors

4931 West 27th Street  
Suite 200  
Eden Prairie, Minnesota  
55344  
T: 952.948.9406  
F: 952.941.8524  
www.wcl.com

JAN 19, 2009

### WEST SHADY NINE

6600 City West Parkway, Eden Prairie, Minnesota

#### CONTACT:

Gary Ryan

952.948.9406 Direct

[gryan@karealty.com](mailto:gryan@karealty.com)



KRAUS-ANDERSON REALTY COMPANY


Development • Leasing • Management

# WEST SHADY NINE OFFICE BUILDING

## 3<sup>rd</sup> Floor

WEST SHADY NINE  
THIRD FLOOR

6600 CITY WEST PARKWAY  
EDEN PRAIRIE, MN

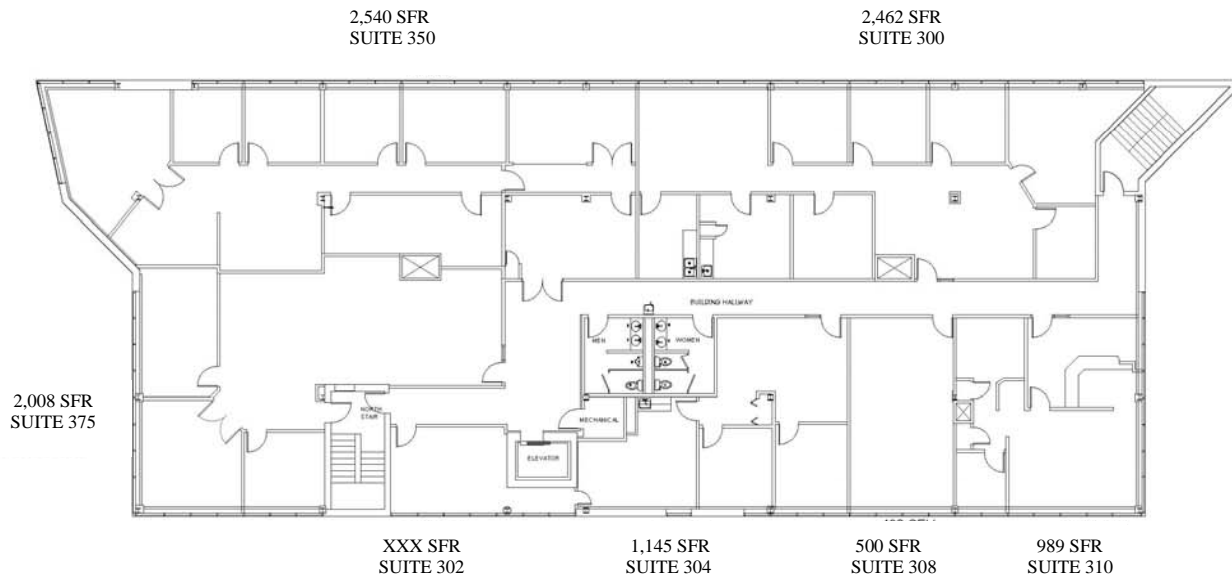

**3**  
**1** FLOOR PLAN: THIRD FLOOR  
AS BUILT

SCALE: 1/16" = 1'-0"



WCL  
ASSOCIATES, INC.

4001 Hwy 210, Suite 200  
St. Louis Park, Minnesota 55426  
T: 952.941.9999  
F: 952.941.9998  
www.wcl.com

JAN 19, 2009

**WEST SHADY NINE**  
6600 City West Parkway, Eden Prairie, Minnesota

**CONTACT:**  
Gary Ryan  
952.948.9406 Direct  
[gryan@karealty.com](mailto:gryan@karealty.com)



**KRAUS-ANDERSON REALTY COMPANY**  
Development • Leasing • Management